




1 Elevation East - Proposed
1:60

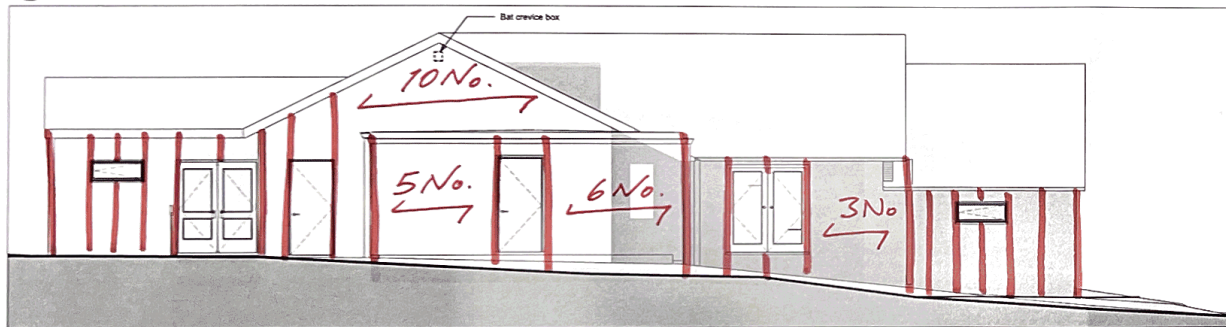

2 Elevation West - Proposed
1:60

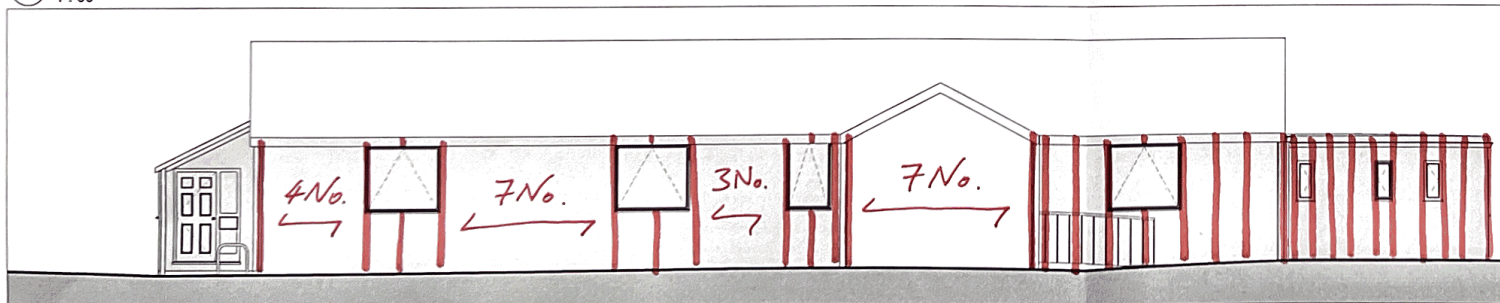

3 Elevation North - Proposed
1:60

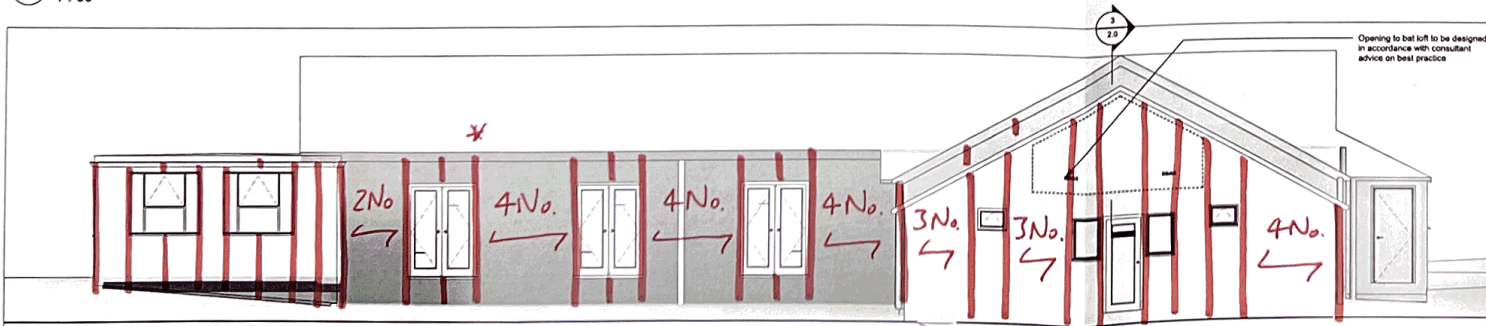

4 Elevation South - Proposed
1:60

2No. 50x75mm C24 battens as Architects details.

Fix back to external leaf of existing using 3No. M10 Resin Anchors per height, top/middle/bottom.

Exact setting out to be confirmed on site.



This drawing is the copyright of Barton Architects & may not be copied, altered or reproduced in any way or passed to a third party without their written authority.
Status

Preliminary

Not for Construction or
Tendering

Issues / Revisions	
A Initial Issue	110523 LB
B Revised to include EC additions	040923 LB
C Corner amended for planning	070923 LB
D Stage 4 Preliminary Issue	181023 LB
E Stage 4 Preliminary Issue	100124 LB

Barton Architects

67 Bedford House, Fulham Green
68-78 Fulham High Street
London, SW6 3JW
admin@bartonarchitects.co.uk
www.bartonarchitects.co.uk

Project
Chittlehampton Village Hall

DRAWING MARK UP

JOB NO.: 06048E

DWG TITLE: EXTERNAL LEAF
BATTENS

DWG NO.: SK06

INITIALS: MDH DATE: JAN 24

SH